


UPPER FLOOR PLAN



GROUND FLOOR PLAN

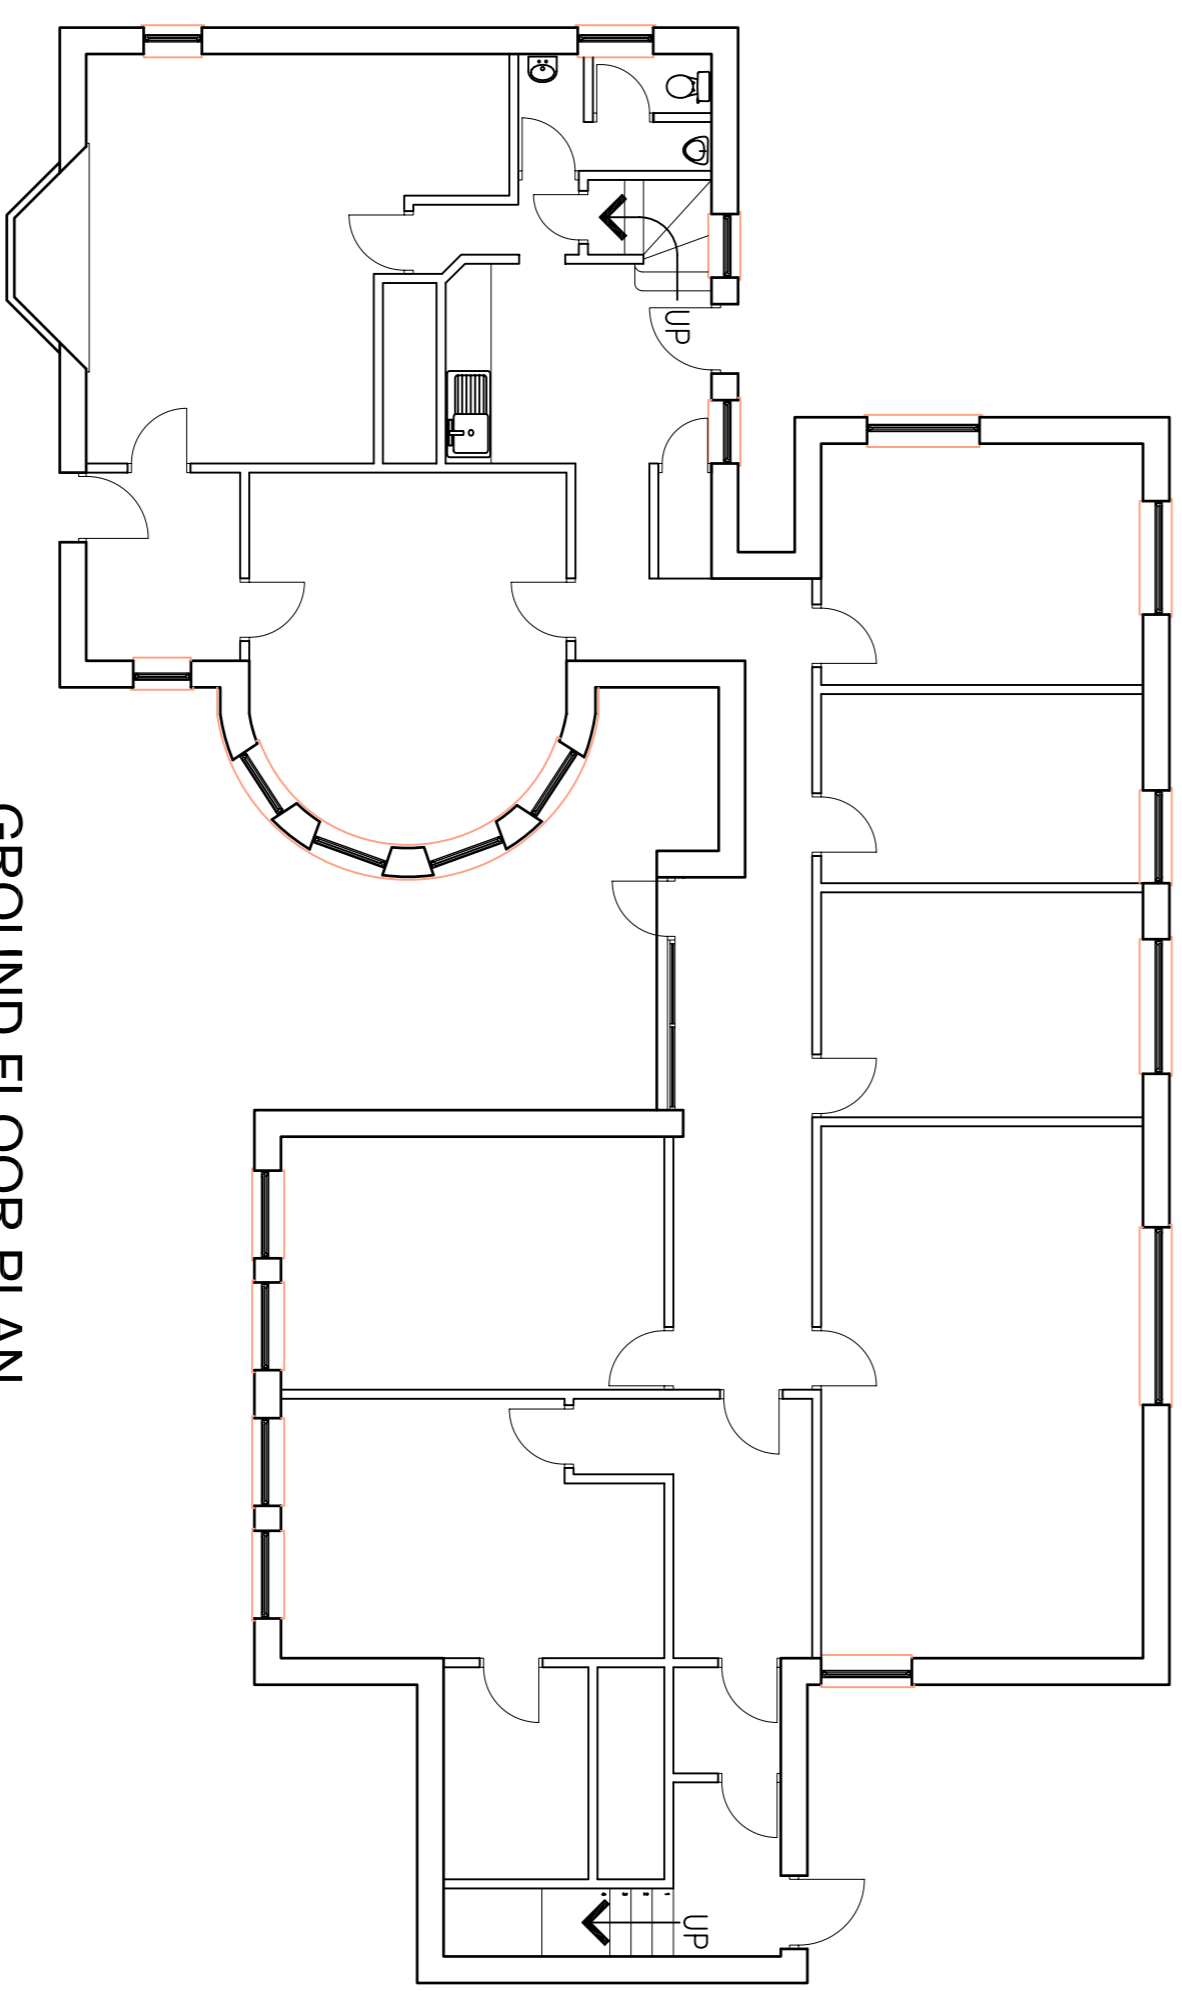

PROJECT:  
 Stirling House  
 Building Number 400

TITLE:  
 Floor Plans

DATE:	SCALE:	DRAWN BY:
July '07	1:100 @ A1	DF
CON REF:	DES STATUS:	
J:\projects\009	AS-Built	
DRW NO:		

Q/1009/033

NO.	DESCRIPTION	DATE	BY